


The copyright of this drawing and of all annexes which are entrusted to a person's care always remain the property of Kongsberg Maritime AS. They must not be copied or duplicated nor shown to or placed at the disposal of third persons without our written consent.

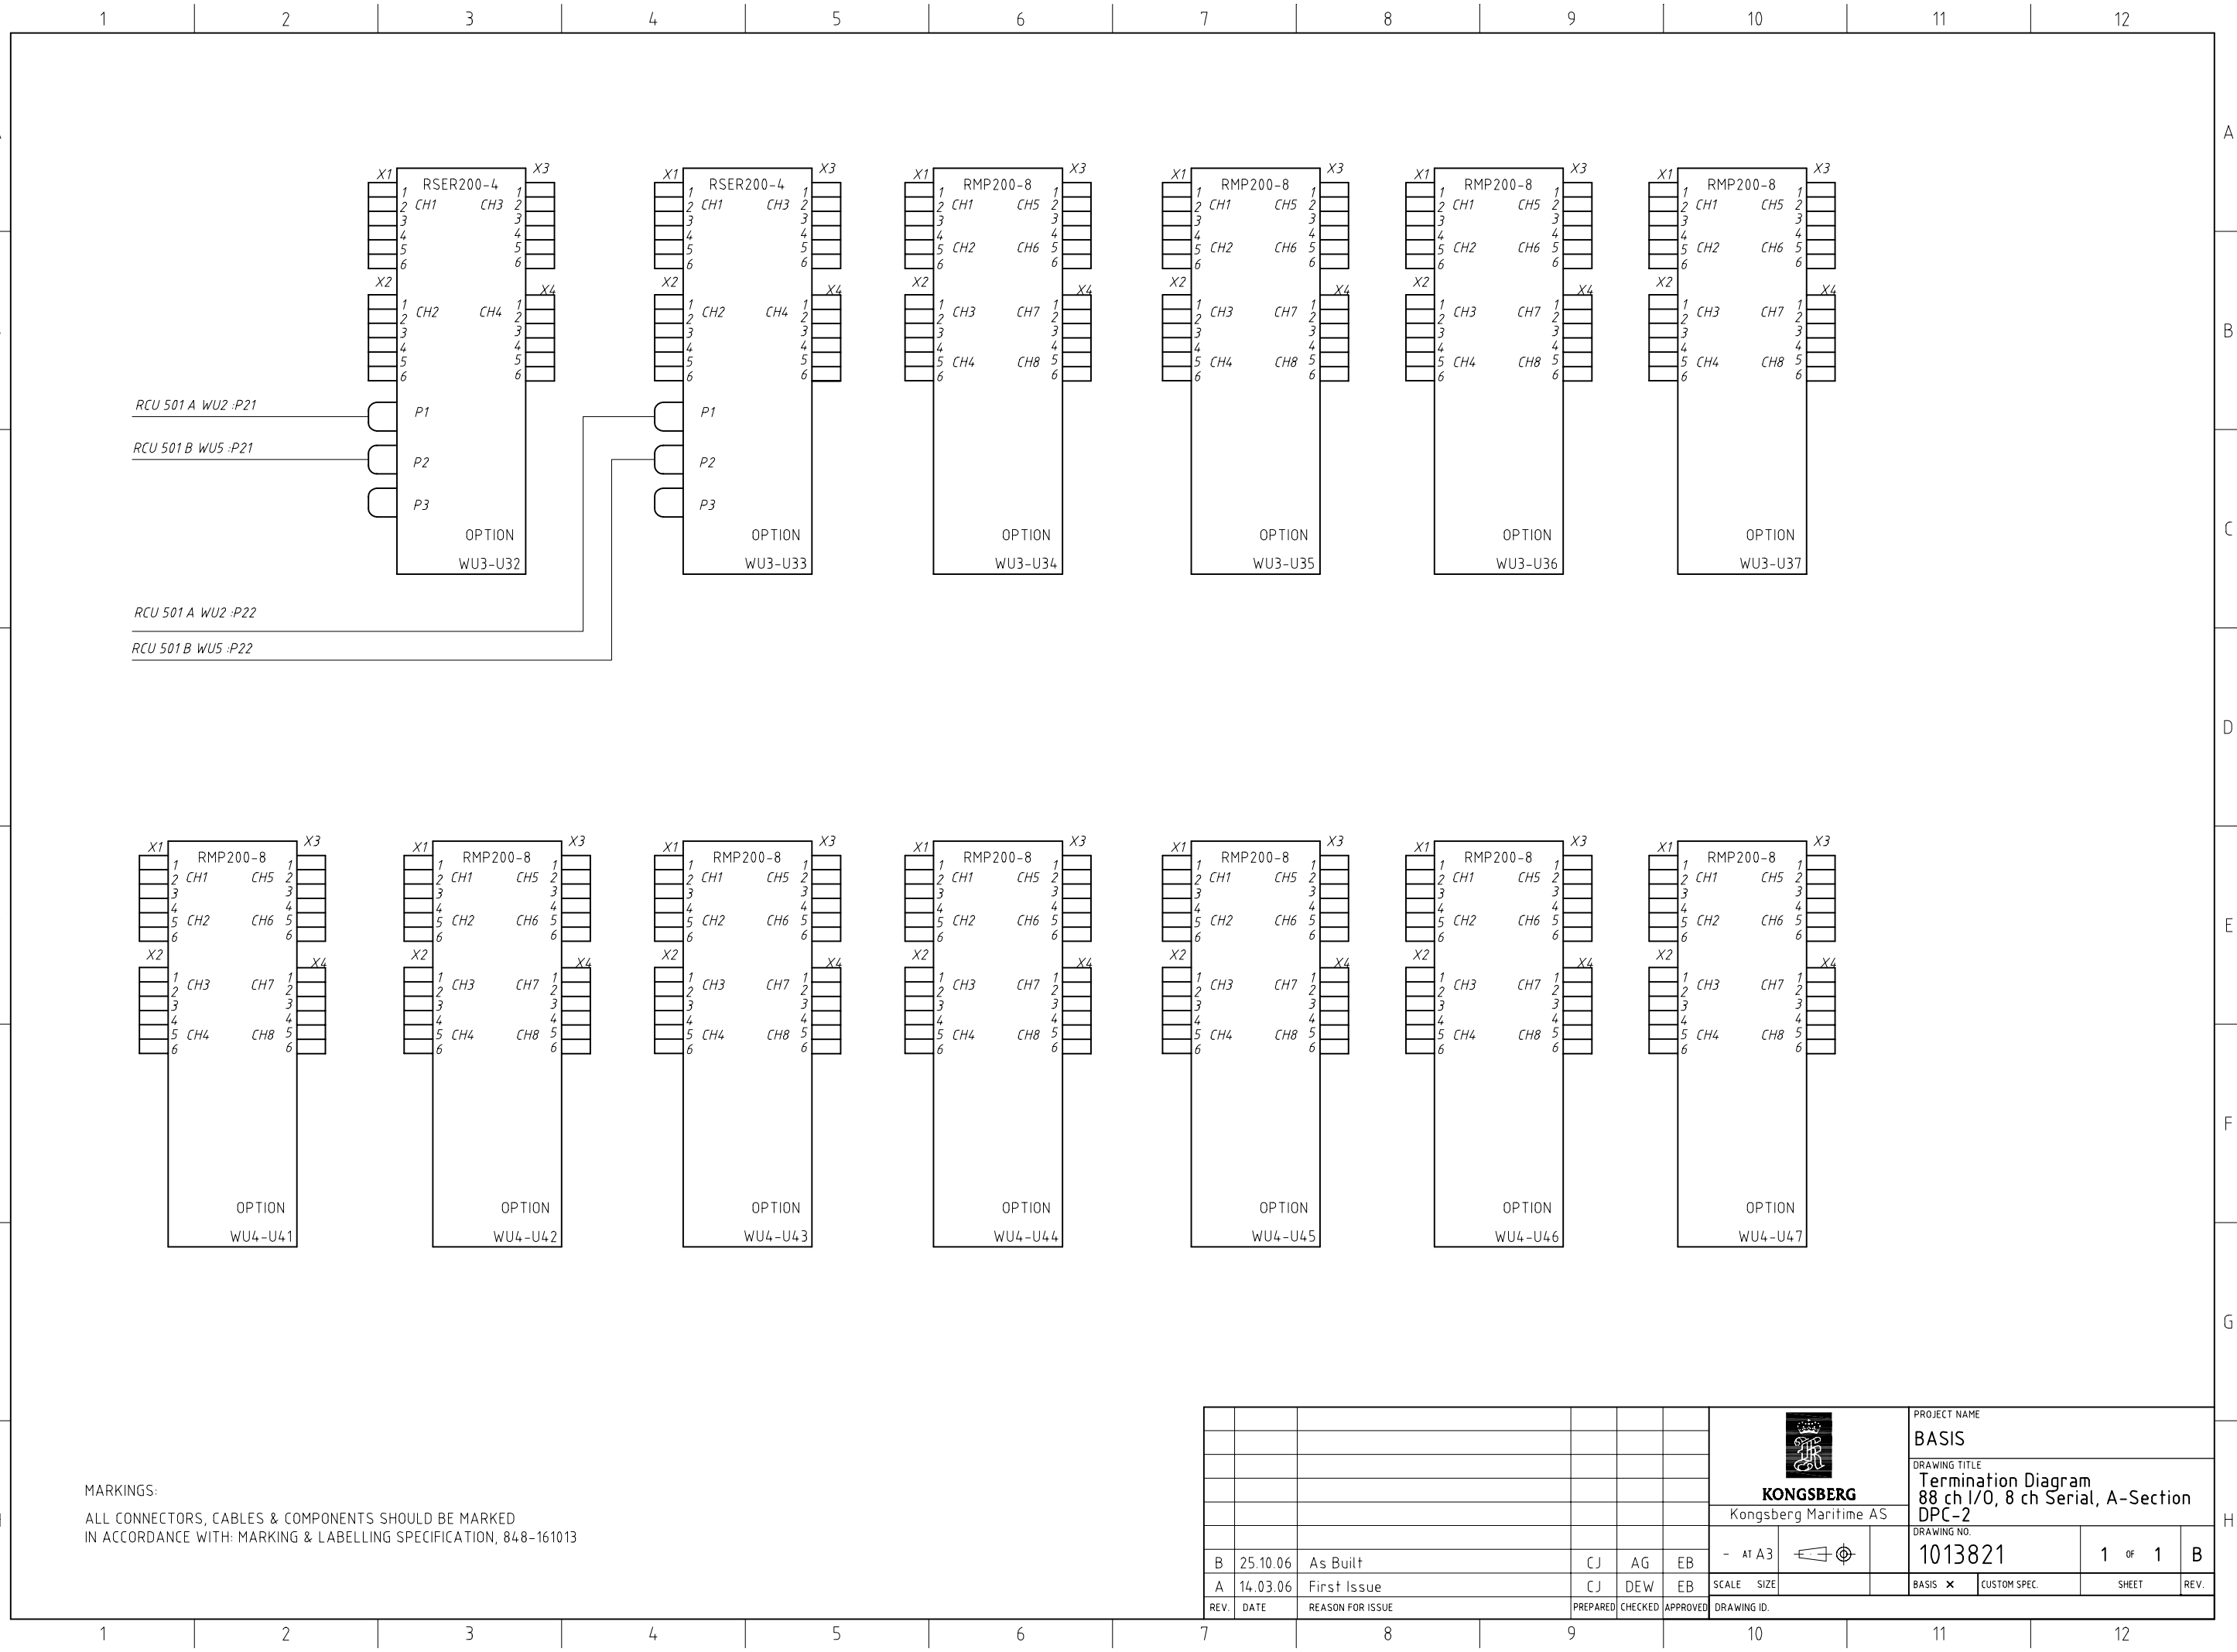

MARKINGS:
ALL CONNECTORS, CABLES & COMPONENTS SHOULD BE MARKED
IN ACCORDANCE WITH: MARKING & LABELLING SPECIFICATION, 848-161013

								PROJECT NAME BASIS		
						KONGSBERG Kongsberg Maritime AS		DRAWING TITLE Termination Diagram 88 ch I/O, 8 ch Serial, A-Section DPC-2		
						- AT A3		DRAWING NO. 1013821		1 OF 1
B	25.10.06	As Built	CJ	AG	EB	SCALE	SIZE	BASIS <input checked="" type="checkbox"/>	CUSTOM SPEC.	SHEET
A	14.03.06	First Issue	CJ	DEW	EB	DRAWING ID.				REV.
REV.	DATE	REASON FOR ISSUE	PREPARED	CHECKED	APPROVED					