



The copyright of this drawing and of all annexes which are entrusted to a person's care always remain the property of Kongsberg Maritime AS. They must not be copied or duplicated nor shown to or placed at the disposal of third persons without our written consent.

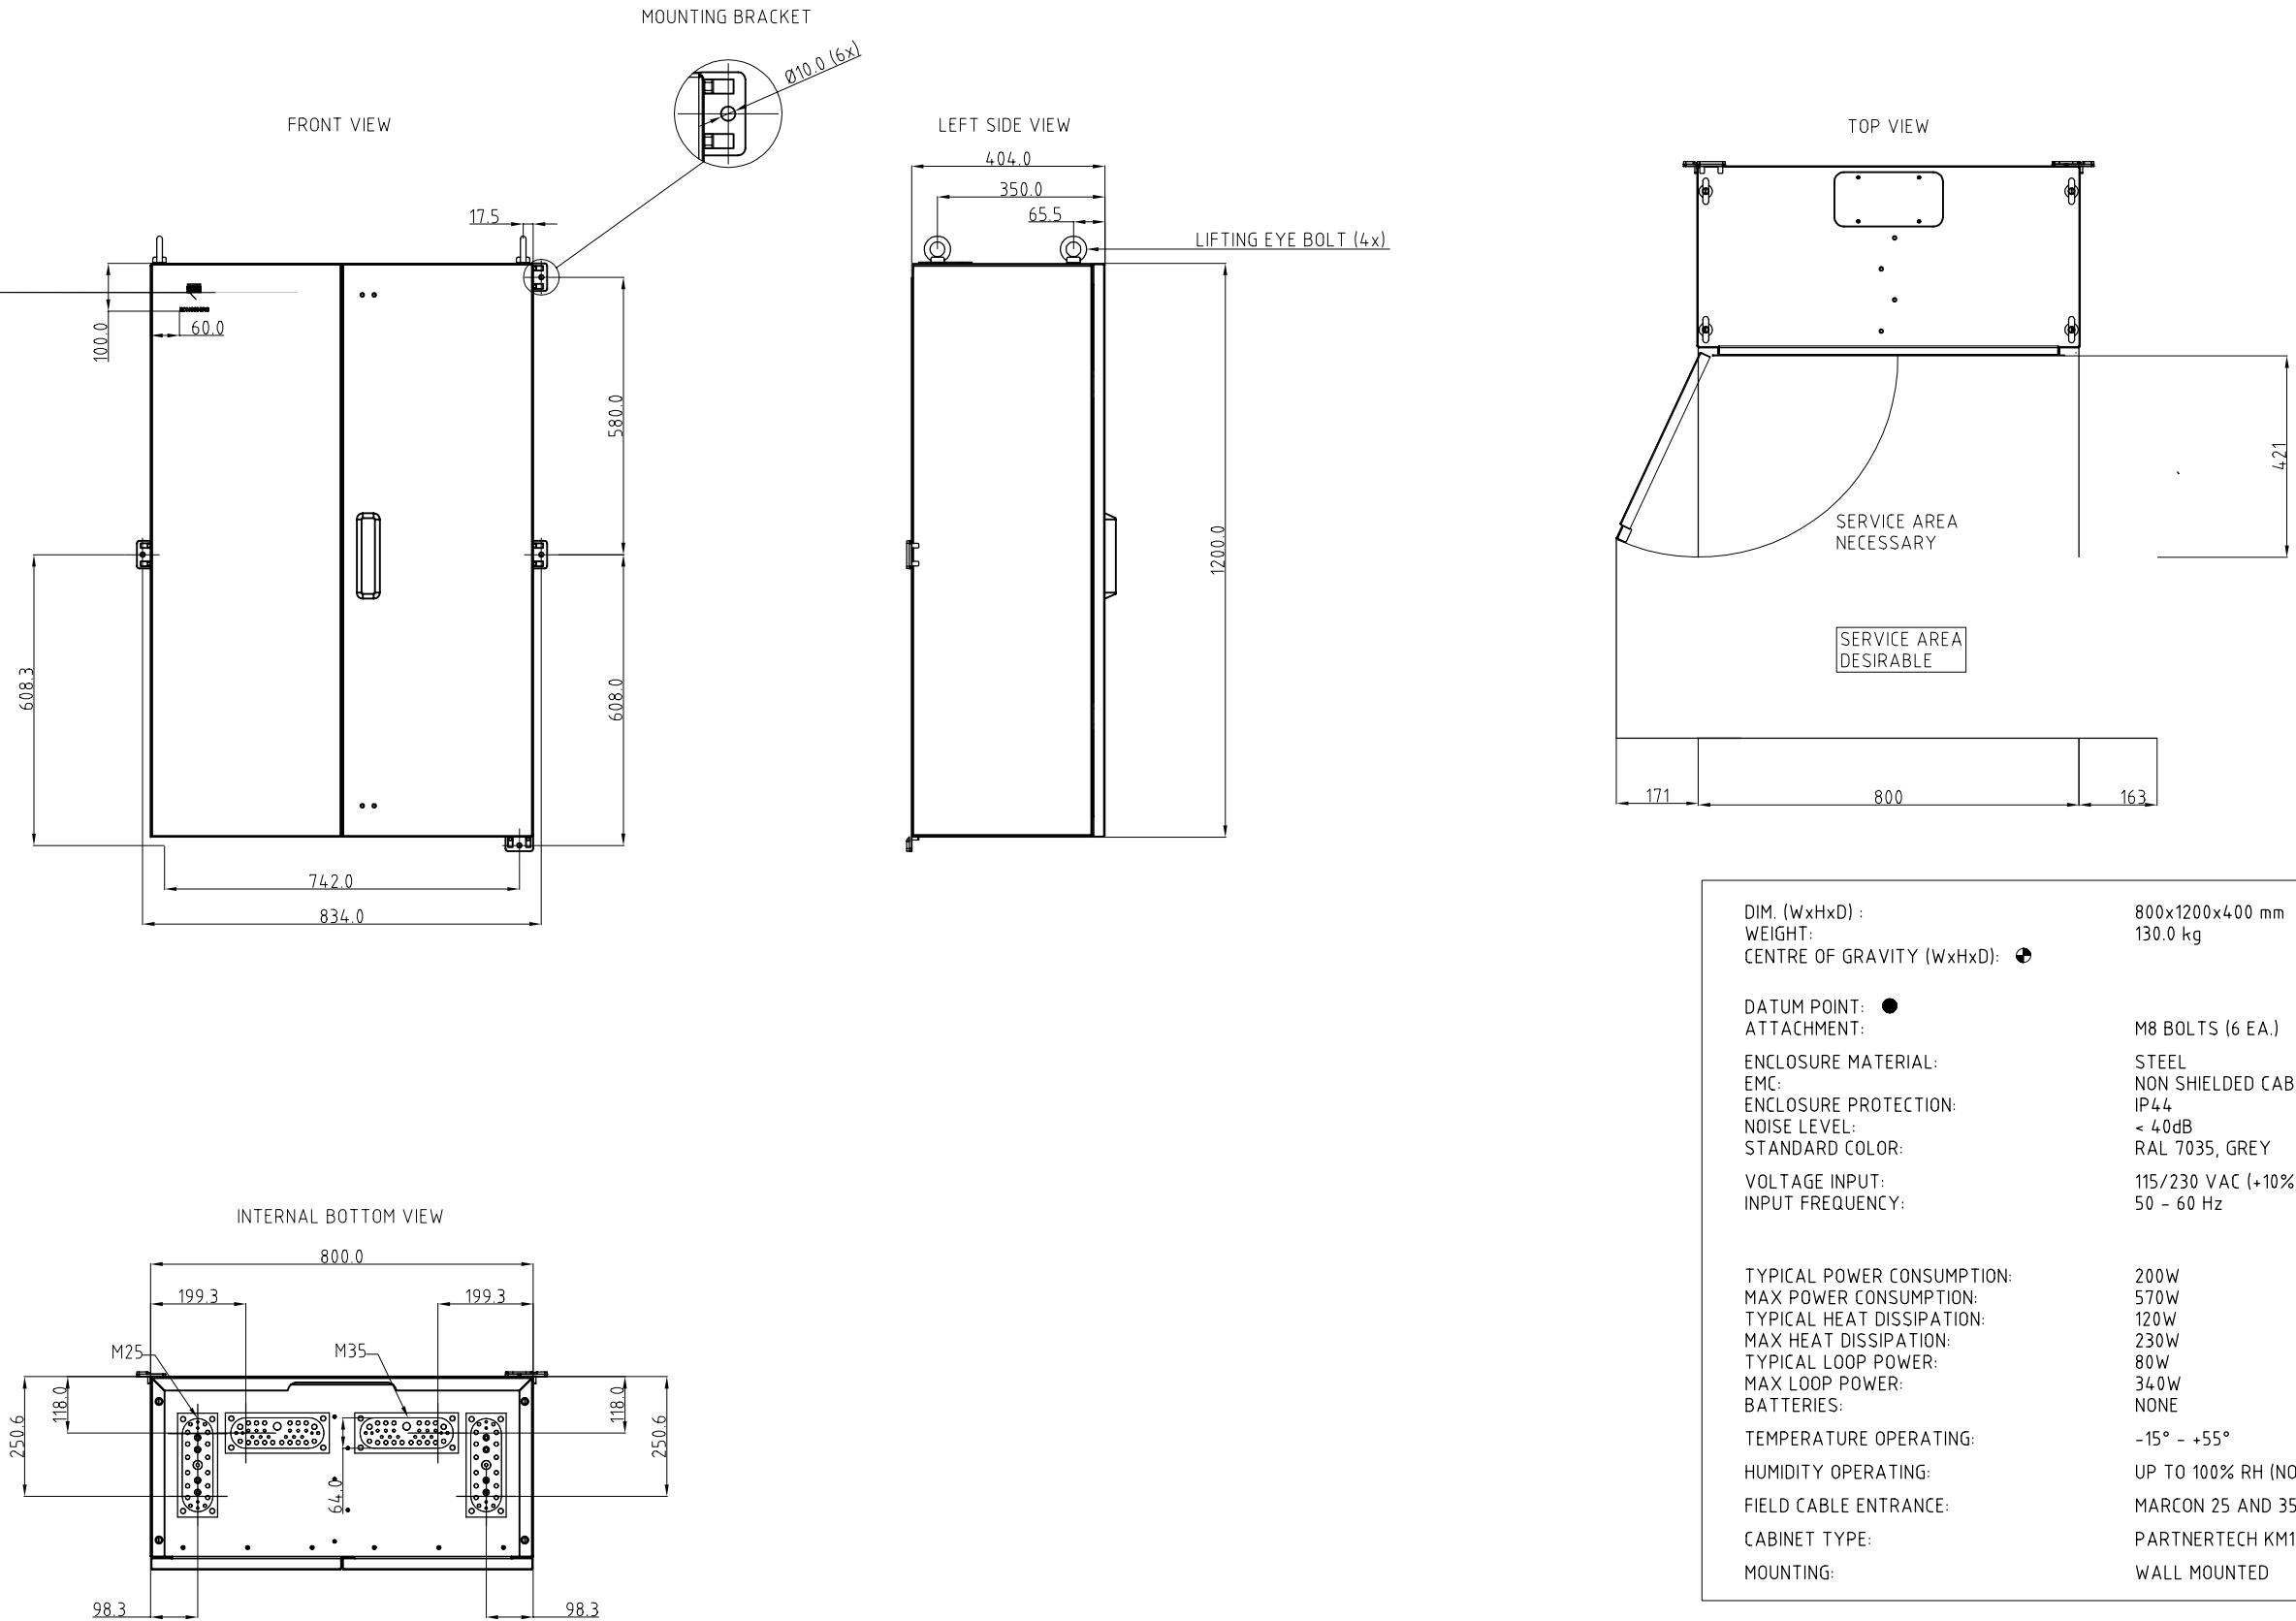

DIM. (WxHxD) :	800x1200x400 mm
WEIGHT:	130.0 kg
CENTRE OF GRAVITY (WxHxD):	●
DATUM POINT:	●
ATTACHMENT:	M8 BOLTS (6 EA.)
ENCLOSURE MATERIAL:	STEEL
EMC:	NON SHIELDED CABINET
ENCLOSURE PROTECTION:	IP44
NOISE LEVEL:	< 40dB
STANDARD COLOR:	RAL 7035, GREY
VOLTAGE INPUT:	115/230 VAC (+10% / -15%)
INPUT FREQUENCY:	50 - 60 Hz
TYPICAL POWER CONSUMPTION:	200W
MAX POWER CONSUMPTION:	570W
TYPICAL HEAT DISSIPATION:	120W
MAX HEAT DISSIPATION:	230W
TYPICAL LOOP POWER:	80W
MAX LOOP POWER:	340W
BATTERIES:	NONE
TEMPERATURE OPERATING:	-15° - +55°
HUMIDITY OPERATING:	UP TO 100% RH (NON-CONDENSING)
FIELD CABLE ENTRANCE:	MARCON 25 AND 35 CONDUCTIVE RUBBER
CABINET TYPE:	PARTNERTECH KM100
MOUNTING:	WALL MOUNTED

						 KONGSBERG Kongsberg Maritime AS		PROJECT NAME BASIS			
								DRAWING TITLE General Arrangement DPC -1 / 2 Cabinet Cabinet 800x1200x400			
								DRAWING NO. 302199		1 OF 1	
C	12.06.07	Removed note	TN	AG	EB	- AT A3		BASIS X		CUSTOM SPEC.	
B	24.10.06	As Built	CJ	AG	EB			SHEET		REV.	
A	17.03.06	FIRST ISSUE	CJ	DEW	EB	SCALE SIZE					
REV.	DATE	REASON FOR ISSUE	PREP.	CHECK.	APPR.	DRAWING ID.					